
[illegible]



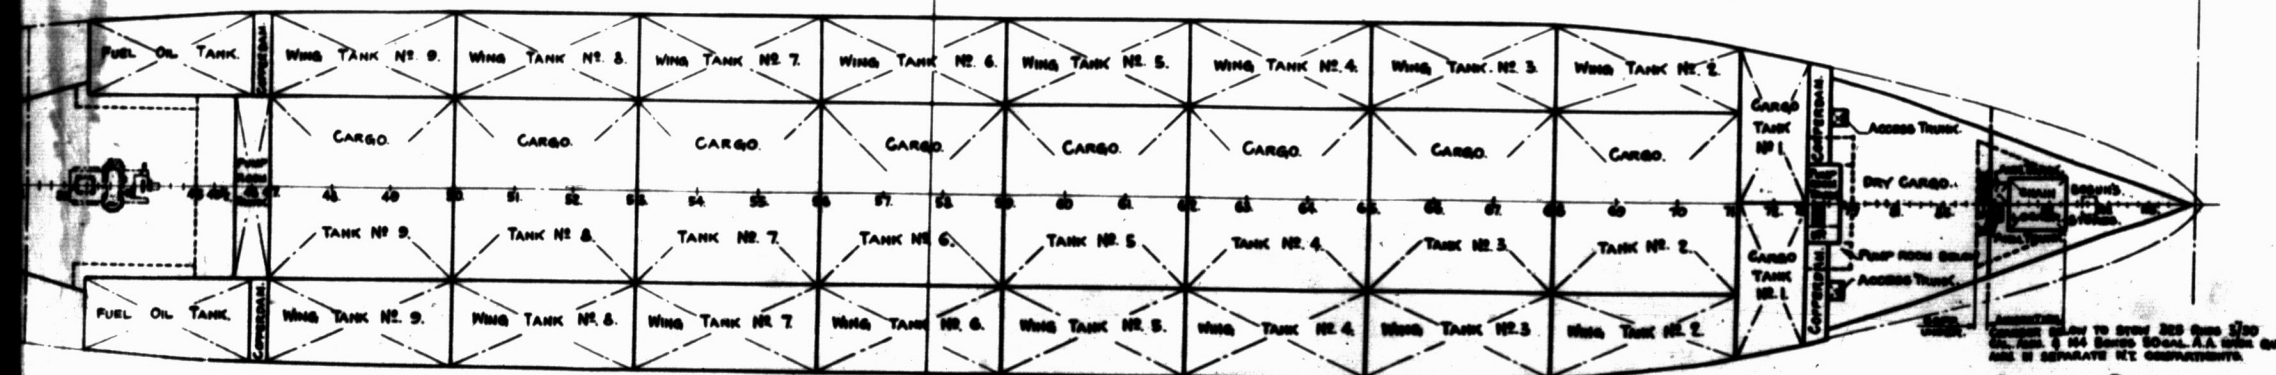

SECOND DECK  
AND  
HOLD PLAN.

ALTERATIONS.		BY		OK	DATE
DESCRIPTION.					
ALL	<p>FOR THE PURPOSE OF THE PROVISIONS OF THE ACT OF 1908, THE FOLLOWING ARE THE ALTERATIONS TO BE MADE IN THE PROVISIONS OF THE ACT OF 1908:</p> <p>1. The word "and" shall be inserted after the word "or" in the first line of the first section of the Act of 1908.</p> <p>2. The word "and" shall be inserted after the word "or" in the second line of the first section of the Act of 1908.</p> <p>3. The word "and" shall be inserted after the word "or" in the third line of the first section of the Act of 1908.</p> <p>4. The word "and" shall be inserted after the word "or" in the fourth line of the first section of the Act of 1908.</p> <p>5. The word "and" shall be inserted after the word "or" in the fifth line of the first section of the Act of 1908.</p> <p>6. The word "and" shall be inserted after the word "or" in the sixth line of the first section of the Act of 1908.</p> <p>7. The word "and" shall be inserted after the word "or" in the seventh line of the first section of the Act of 1908.</p> <p>8. The word "and" shall be inserted after the word "or" in the eighth line of the first section of the Act of 1908.</p> <p>9. The word "and" shall be inserted after the word "or" in the ninth line of the first section of the Act of 1908.</p> <p>10. The word "and" shall be inserted after the word "or" in the tenth line of the first section of the Act of 1908.</p>				

APPROVED AS NOTED. ALT 12  
M.C.E. LETTER DATED 2-11-44 A.B.S. LETTER \_\_\_\_\_  
M.C.E. FILE NO. 1059-333-1-1 \_\_\_\_\_  
BY Signed: H.E. Sp Clair S.M.I.N. LETTER \_\_\_\_\_  
BY \_\_\_\_\_

[illegible]

REFERENCES		
NO.	TITLE	DRAWING NO.
1	GENERAL ARBOT. QTRS AFT - 1/8" SCALE	S-2294-A
2	" " " FWD " "	S-2294-B
3		
4		
5		
6		
7		
8		
9		
10		
11		
12		

**MARINSHIP CORPORATION.**

**TITLE-** **GENERAL ARRANGEMENT PLAN.**

SCALE 1/2" = 1 FOOT	DATE July 4 - 1966
DRAWN	APPROVED <i>[Signature]</i>
TITLED R. E. POOL	APPROVED
CHECKED <i>[Signature]</i>	APPROVED <i>[Signature]</i>
FULL NO. 1000 - 1009 40 - 49	MARSHALL FILED T2-5103-1

48-43  
2-102-1